

Essence Lounge LLC
917 26th Street S
La Crosse, WI 54601

Re: Seeking Permission to Apply for a Combination "Class B" Beer & Liquor License

To the Honorable Mayor and Members of the Common Council,

This letter seeking permission to apply is for Essence Lounge LLC locate at 917 26th Street S., La Crosse, WI in order to apply for a Combination Class B Beer and Liquor License.

The proposed business is a tavern with a bar program and food. The tavern portion will provide beverage and bar program, including food, for dine in guests. The facility was previously home to the Mirage Bar.

The estimated gross receipts of beer, wine, & liquor in relation to total goods sold will be a substantial portion of the gross receipts.

Ownership: Ashly Pappas, Essence Lounge LLC

Type of Business: Tavern

Number of Employees: Approximately 7


Hours of Operation: Sunday-Monday 10:30 a.m. to 2:00 a.m.

See attached floor plan.

Thank you for your consideration:

Ashly Pappas
Ashly Pappas


11/04/2021
Date

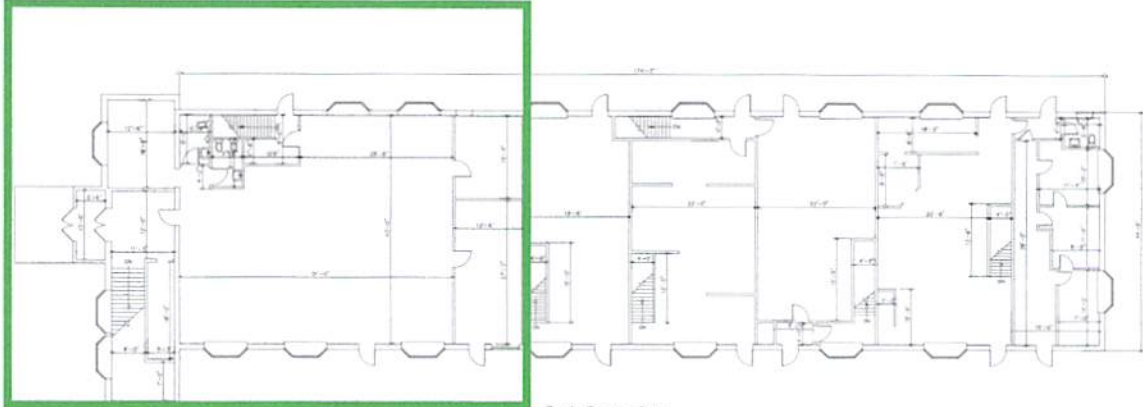

first floor plan

1/8" = 1'-0"

EMERGENCY LINES HAVE PRIORITY

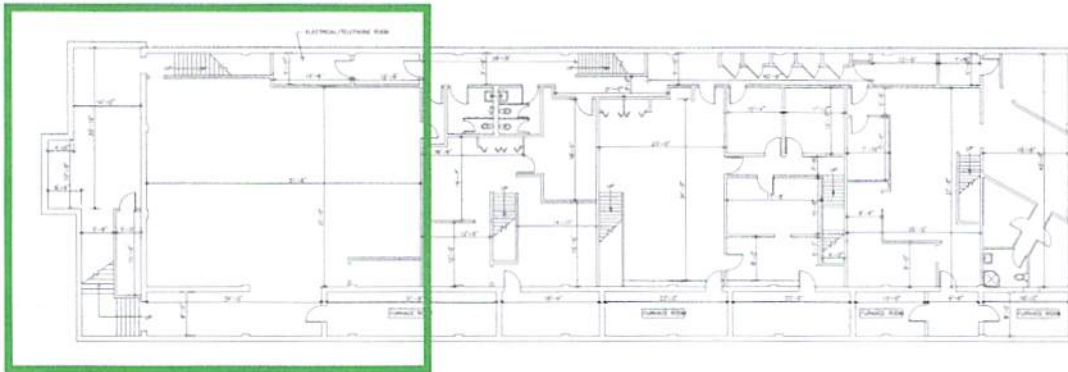

basement floor plan

1/8" = 1'-0"

ROSEDALE COURT "AS-BUILTS"
 4329 MORMON COULEE ROAD
 LACROSSE, WISCONSIN



CHRIS C. OLSON ENG.
 LACROSSE, WISCONSIN
 DRAWN BY: TSK
 DATE: 3-27-92