

Beautify La Crosse Planting Application

Name: Aric Sampson

Address: 1522 Green Bay St. City: La Crosse State: WI Zip: 54601

Phone: 608-461-0226 Email: eric.sampson.cre@gmail.com

Location Type: please check appropriate boxes below:

Boulevard Traffic Circle Median Park Other, please explain:

Location, Address, or Parcel Number: 1527 Green Bay St. LaCrosse WI

What is your intention for this area? please check appropriate boxes below:

Maintenance New Planting Other, please explain: _____

Project Materials: Please attach additional pages as necessary.

Please provide a concept design including dimensions, materials and plant species list. A three year minimum commitment is required for new projects. See recommended plant species list as well as other resources available on pg. 2.

Materials: see attached plan

Plant List: see attached plan

Maintenance Plan:

How will the project area be maintained? Applicant is responsible for general maintenance including weeding, watering, trimming and removal of excess material.

will occur in tandem with general shop maintenance

SUBMIT YOUR APPLICATION TO CITY OF LA CROSSE PARKS, RECREATION AND FORESTRY DEPARTMENT.

MAIL TO: 400 LA CROSSE ST.

EMAIL MEYERS@CITYOFLACROSSE.ORG



FOR OFFICE USE ONLY

Approved By: _____

Name (Print): _____

Signature: _____ Date: _____

Botanical Name	Common Name	Height (in)
Agastache foeniculum	Anise Hyssop	24-36
Allium stellatum	Prairie Onion	12-24
Antennaria plantaginifolia	Pussytoes	6-12
Asclepias tuberosa	Butterfly Milkweed	18-30
Asclepias verticillata	Whorled Milkweed	18-30
Bouteloua curtipendula	Side Oats Grama	24-36
Bouteloua gracilis	Blue Grama	12-18
Carex bicknellii	Copper Shouldered Oval Sedge	12-24
Coreopsis lanceolata	Lanceleaf Coreopsis	12-24
Dalea candida	White Prairie Clover	18-30
Dalea purpurea	Purple Prairie Clover	18-36
Geum triflorum	Prairie Smoke	12-18
Helopsis helianthoides	Early Sunflower	24-36
Juncus tenuis	Path Rush	8-12
Liatris cylindracea	Cylindrical Blazing Star	18-30
Liatris aspera	Rough Blazing Star	24-36
Monarda fistulosa	Wild Bergamot	24-36
Oenothera serrulata	Prairie Sundrops	12-24
Penstemon digitalis	Foxglove Beardtongue	24-36
Penstemon hirsutus	Hairy Beardtongue	12-24
Phlox pilosa	Prairie Phlox	12-24
Ratibida columnifera	Long Headed Coneflower	24-36
Rudbeckia hirta	Black Eyed Susan	18-36
Schizachyrium scoparium	Little Bluestem	24-36
Sporobolus heterolepis	Prairie Dropseed	24-36
Solidago nemoralis	Gray Goldenrod	12-24
Symphoricarum sericeum	Silky Aster	18-24
Tradescantia ohioensis	Ohio Spiderwort	24-36
Zizia aurea	Golden Alexanders	18-36

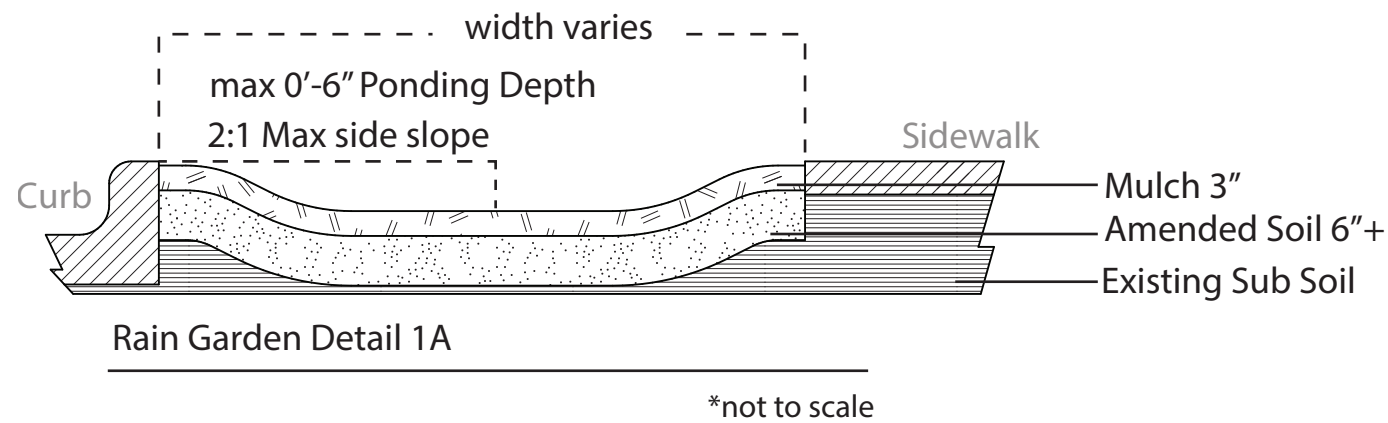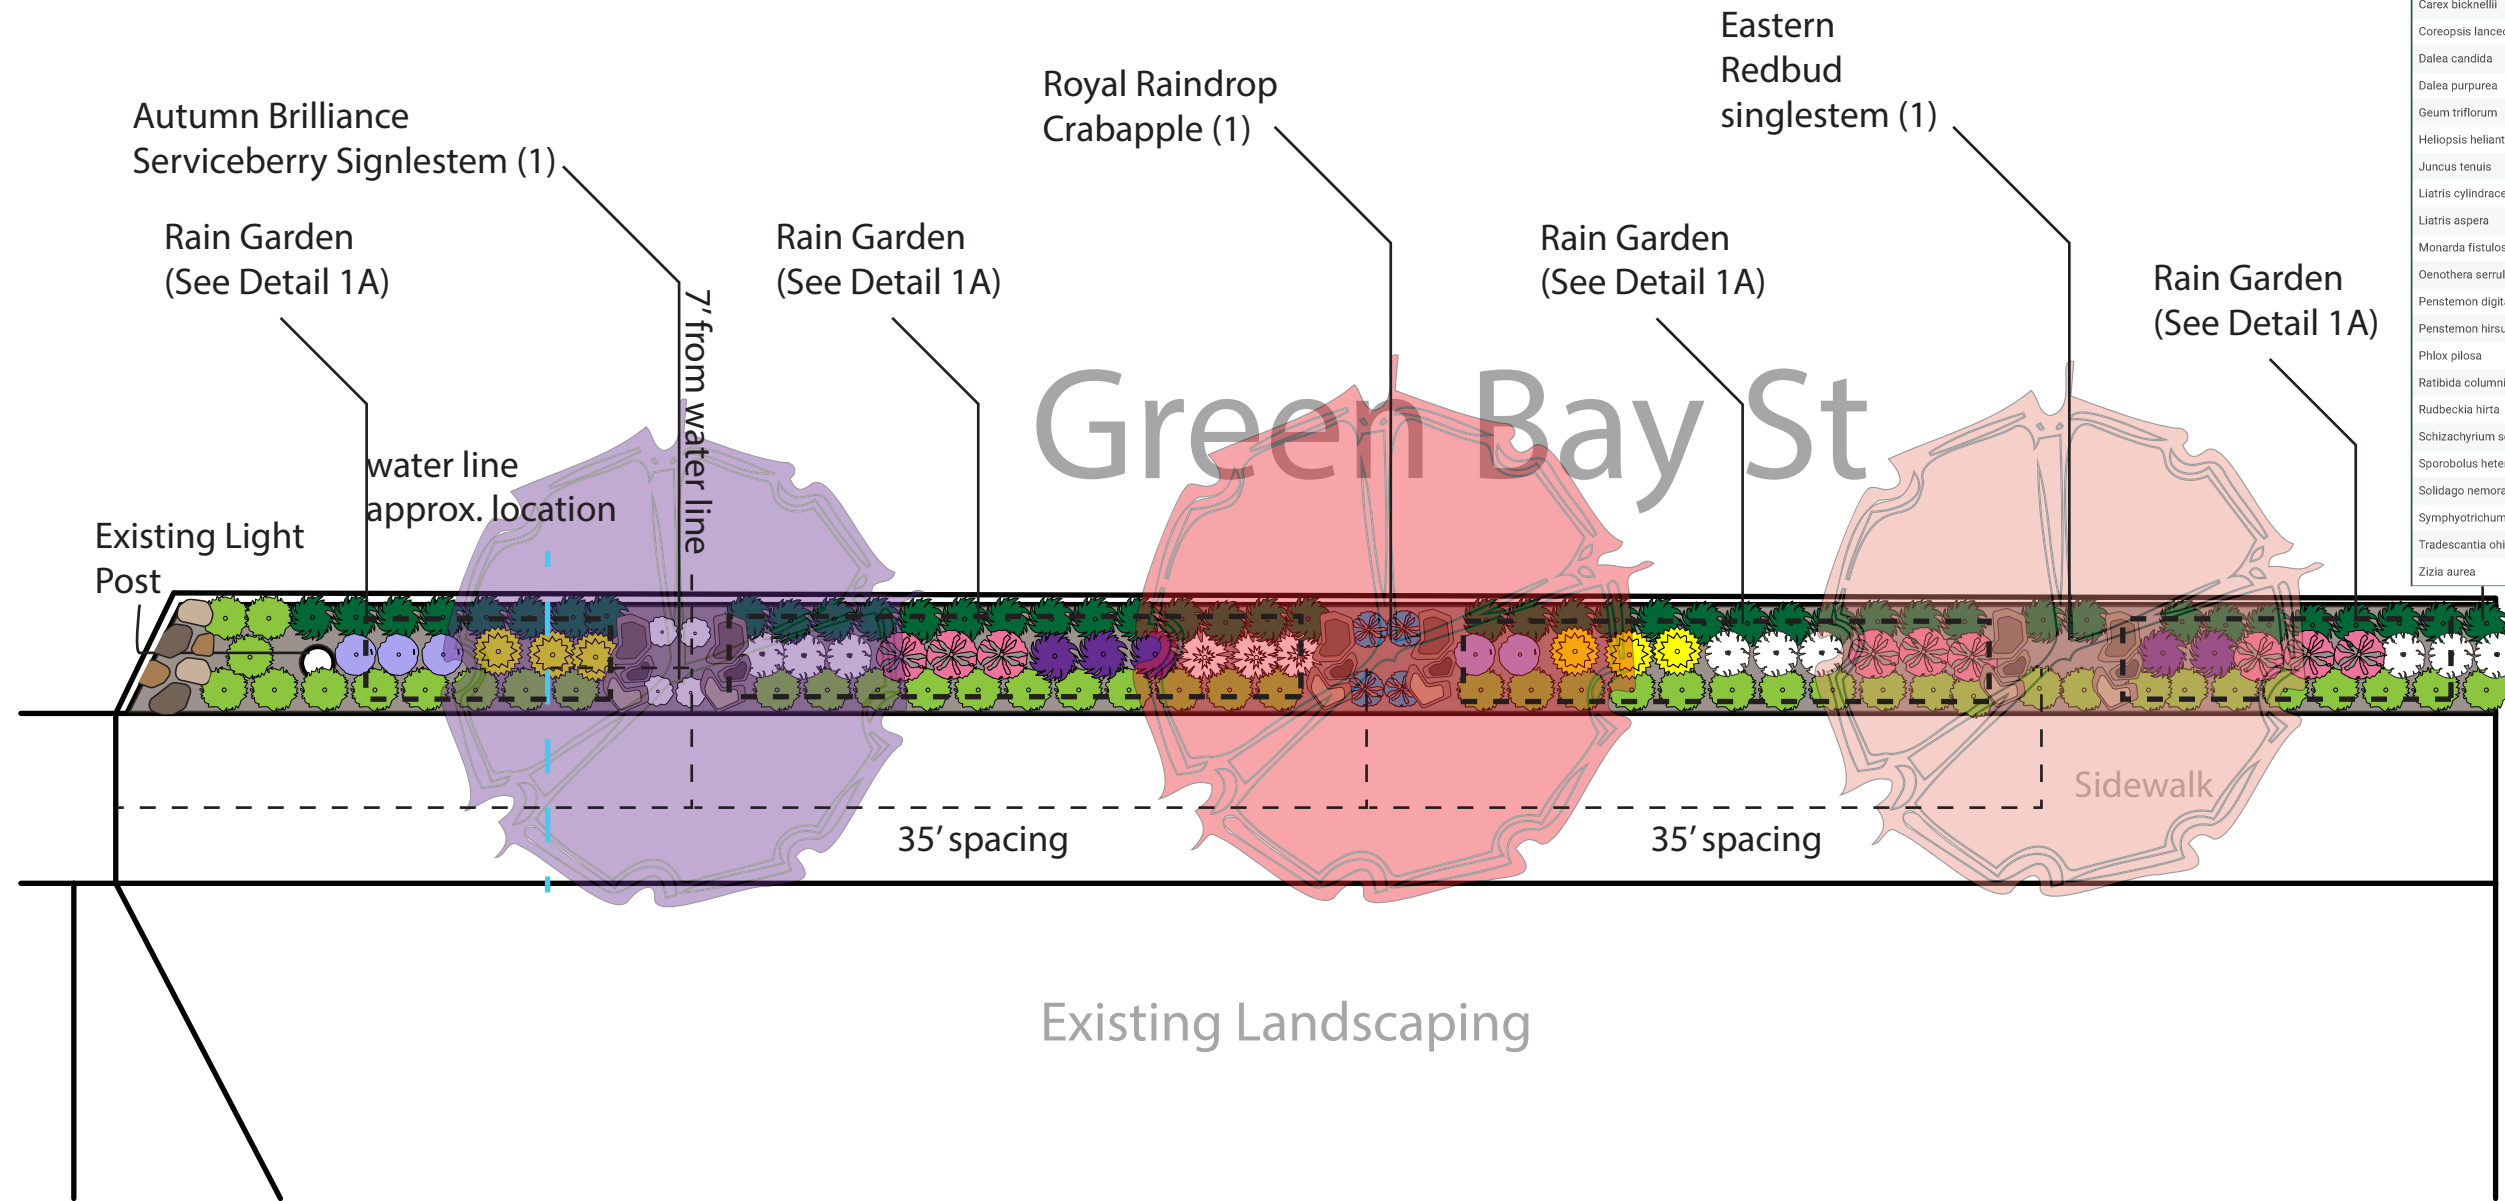

*Pending approval, trees to be installed Fall of 2025/Spring of 2026

*Rain Garden herbaceous plants to be designed in tandem with City of La Crosse Parks and Forestry Department and installed spring of 2026



1522 Green Bay St.
 La Crosse, WI 54601
 (608) 739-2797
 couleeregionecoscapescapes@gmail.com

1522 Green Bay St


Title:
 Concept Plan

Project Location:
 1522 Green Bay St
 La Crosse WI



Revision Date:
 10/19/2025

Scale: 1:10

Sheet Number:
 A-1

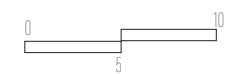


Botanical Name	Common Name	Height (in)
Agastache foeniculum	Anise Hyssop	24-36
Allium stellatum	Prairie Onion	12-24
Antennaria plantaginifolia	Pussytoes	6-12
Asclepias tuberosa	Butterfly Milkweed	18-30
Asclepias verticillata	Whorled Milkweed	18-30
Bouteloua curtipendula	Side Oats Grama	24-36
Bouteloua gracilis	Blue Grama	12-18
Carex bicknellii	Copper Shouldered Oval Sedge	12-24
Coreopsis lanceolata	Lanceleaf Coreopsis	12-24
Dalea candida	White Prairie Clover	18-30
Dalea purpurea	Purple Prairie Clover	18-36
Geum triflorum	Prairie Smoke	12-18
Helianthus annuus	Early Sunflower	24-36
Juncus tenuis	Path Rush	8-12
Liatris cylindracea	Cylindrical Blazing Star	18-30
Liatris aspera	Rough Blazing Star	24-36
Monarda fistulosa	Wild Bergamot	24-36
Oenothera serrulata	Prairie Sundrops	12-24
Penstemon digitalis	Foxglove Beardtongue	24-36
Penstemon hirsutus	Hairy Beardtongue	12-24
Phlox pilosa	Prairie Phlox	12-24
Ratibida columnifera	Long Headed Coneflower	24-36
Rudbeckia hirta	Black Eyed Susan	18-36
Schizachyrium scoparium	Little Bluestem	24-36
Sporobolus heterolepis	Prairie Dropseed	24-36
Solidago nemoralis	Gray Goldenrod	12-24
Symphoricarpos racemosa	Silky Aster	18-24
Tradescantia ohiensis	Ohio Spiderwort	24-36
Zizia aurea	Golden Alexanders	18-36

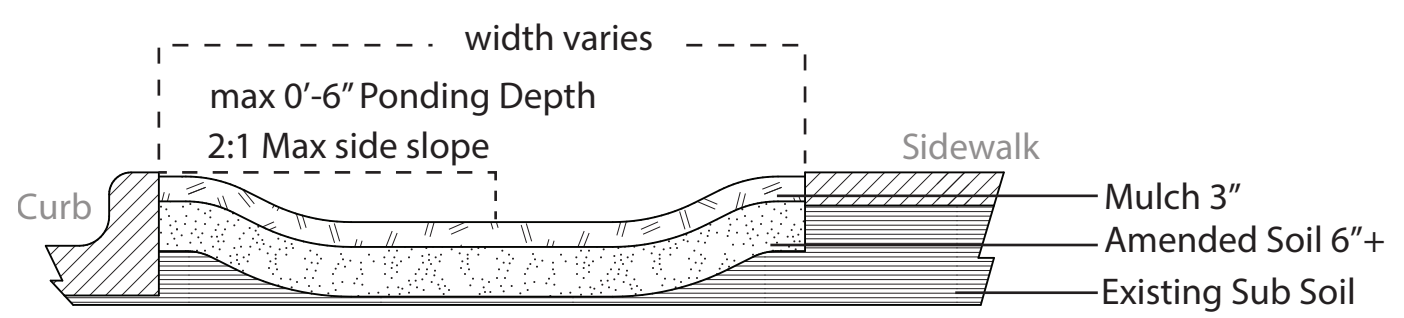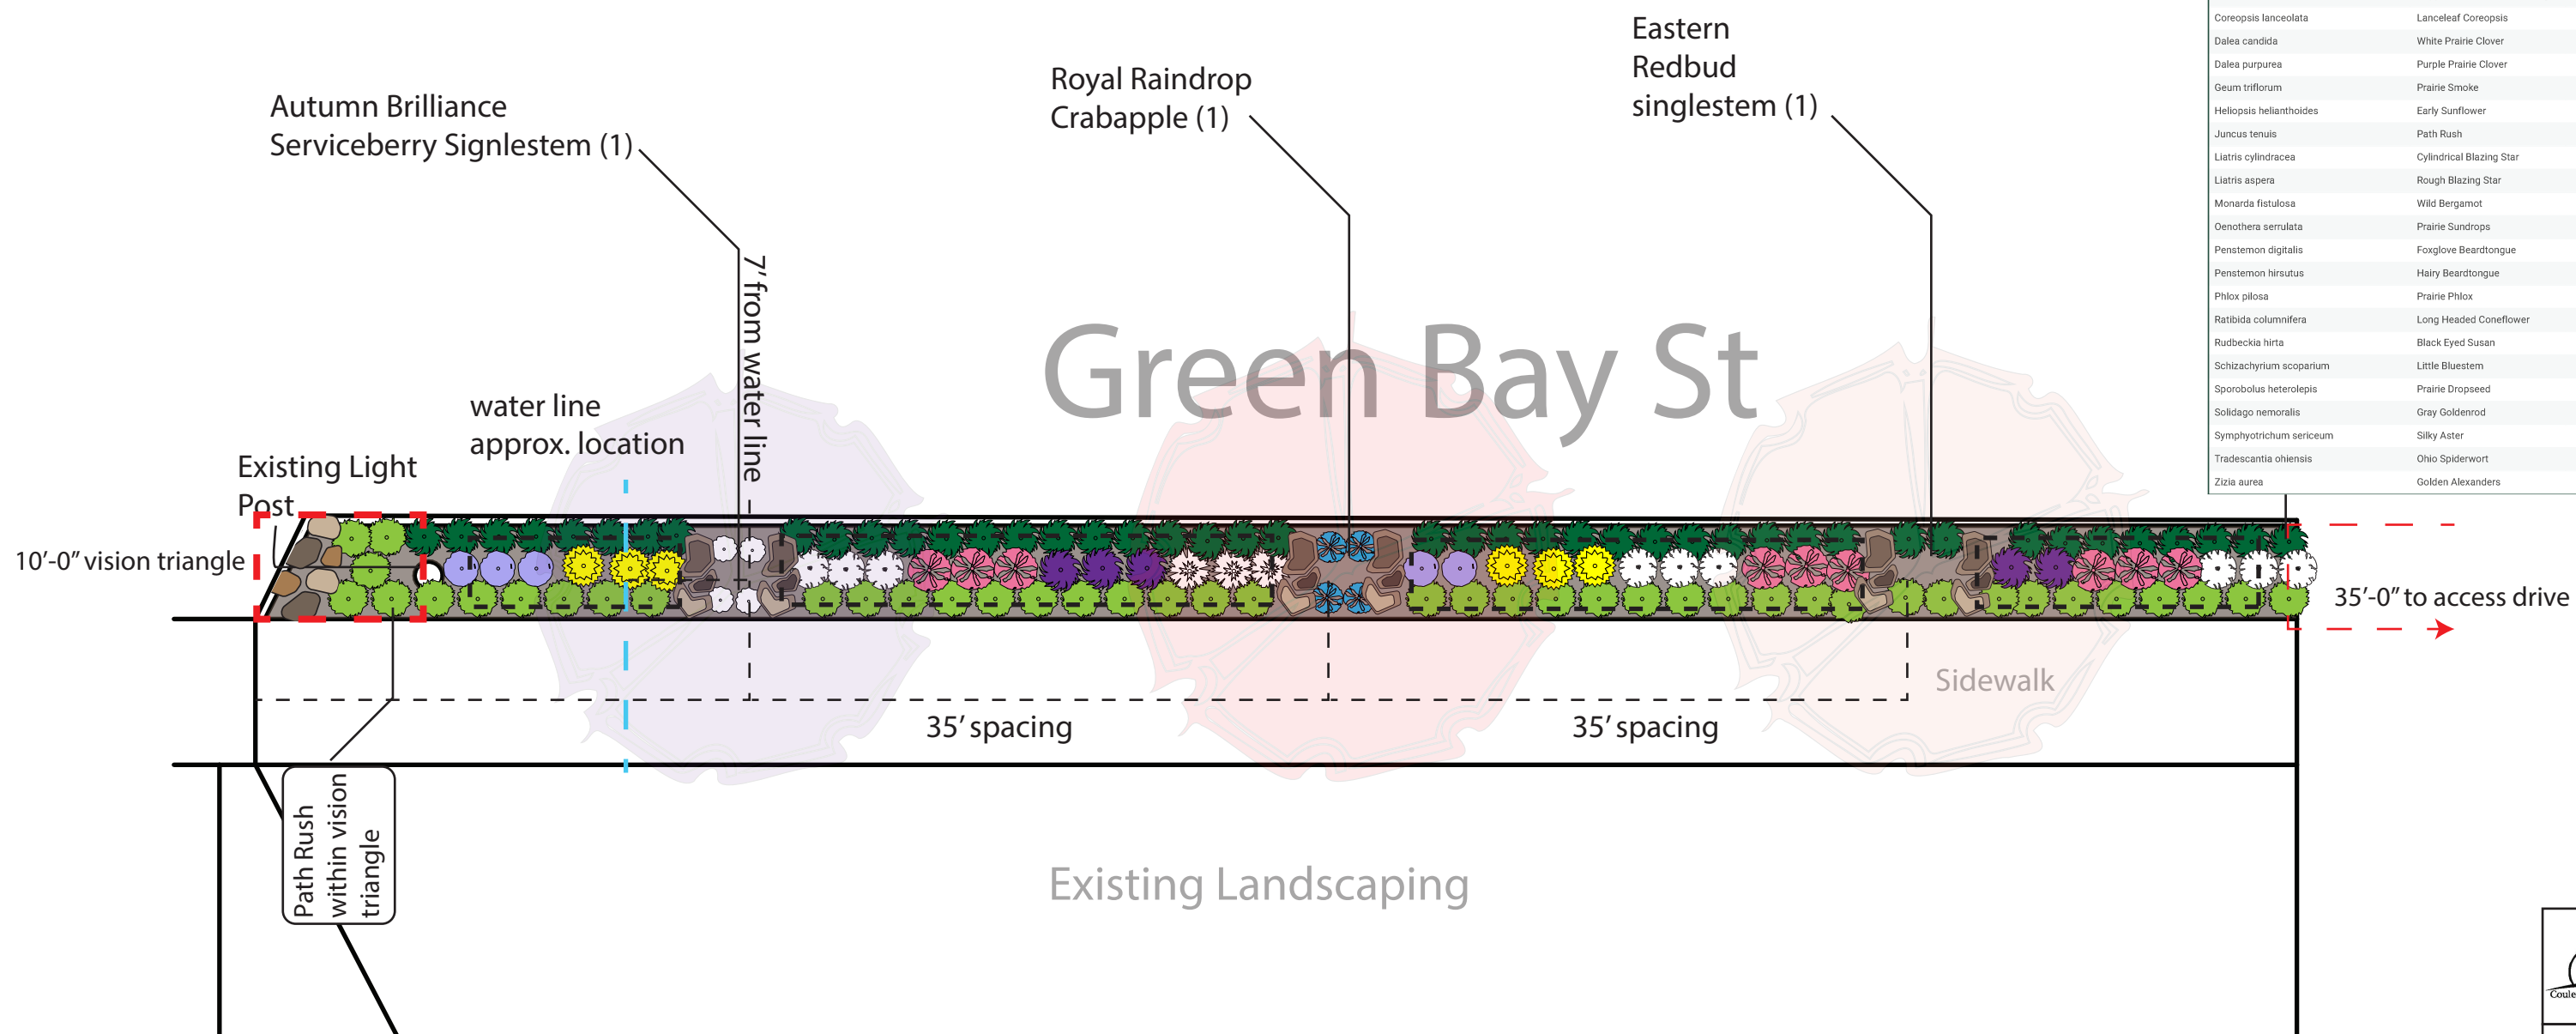

*not to scale

*Pending approval, trees to be installed Fall of 2025/Spring of 2026

*Rain Garden herbaceous plants to be designed in tandem with City of La Crosse Parks and Forestry Department and installed spring of 2026

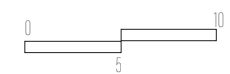



Coulee Region Ecoscapes LLC

1522 Green Bay St.
La Crosse, WI 54601

(608) 739-2797

coulee@regionecoscapes@gmail.com

1522 Green Bay St

Title:
Herbaceous Planting Plan

Project Location:
1522 Green Bay St
La Crosse WI

Revision Date:
10/19/2025

Scale: 1:10

Sheet Number:
A-1