

REVISIONS	DATE
CONSTRUCTION BULLETIN #1	10/23/25
CONSTRUCTION BULLETIN #2	10/28/25
CONSTRUCTION BULLETIN #4	12/16/25
CONSTRUCTION BULLETIN #5	02/10/26

PARAGON ASSOCIATES
 Environmental Design & Consulting
 CIVIL ENGINEERING · LANDSCAPE ARCHITECTURE · SURVEYING
 632 COPELAND AVENUE · LA CROSSE, WI 54603
 Tel: 608.781.3110 Fax: 608.781.3197 Paragon-Associ.biz

PREPARED FOR:
DALE JACOBSON

HIGHWAY 16 CLINICS
 STATE ROAD 16
 LA CROSSE, WISCONSIN
 UTILITY PLAN

DRAWN
 C.G.
 PROJECT No
 25-089
 DATE
 10/15/2025
 SCALE
 1"=20'
 CAD FILE
 25-089 La Crosse Vet 10.dwg
 SHEET

C400

NOTES

- SEE DETAIL (F) FOR MANHOLE FOR STORM SEWER
- SEE DETAIL (G) FOR STORM SEWER INLET 3' X 2'
- SEE DETAIL (H) FOR 18" NDS INLET
- SEE DETAIL (I) FOR 12" NDS INLET
- SEE DETAIL (J) FOR CLEAN OUT
- SEE DETAIL (K) FOR DOWNSPOUT
- 24" INSPECTION PORT: NYLOPLAST RISER WITH 24" SOLID, TRAFFIC RATED COVER. PROVIDE 8" (18" IN LAWN AREAS) REINFORCED CONCRETE COLLAR AROUND RISER COVER, SET IN 6" AGGREGATE BASE. COLLAR SHALL BE 12" CLEAN OF FRAME.
- ALL STORM PIPES CONNECTING TO 48" STORAGE PIPES (OTHER THAN END CONNECTIONS) SHALL HAVE AN INSERTA TEE CONNECTION.
- SEE DETAIL (L) FOR UNDERGROUND STORMWATER STORAGE CHAMBER SYSTEM

UTILITY NOTES

ALL WATER & SEWER (STORM & SANITARY) CONSTRUCTION SHALL COMPLY WITH THE LATEST EDITION OF "STANDARD SPECIFICATIONS FOR SEWER & WATER IN THE STATE OF WISCONSIN," ALONG WITH THE CITY OF LA CROSSE STANDARD SPECIFICATIONS, AS APPROPRIATE.

ALL WATER & SANITARY LATERALS SHALL HAVE A MINIMUM DEPTH 6" BELOW FINISHED FLOOR ELEVATIONS. THE CONTRACTOR IS TO COORDINATE ACTIVITIES & CONFIRM LOCATION & ELEVATION OF SERVICES WITH THE ENGINEER.

USE C.L.D.I.P. FOR ALL WATER MAIN.

ALL WATER MAINS SHALL HAVE A MINIMUM OF 7.5' OF COVER.

SUITABLE ON-SITE GRANULAR MATERIAL SHALL BE USED FOR TRENCH BACKFILL TO PROPOSED ELEVATIONS. BACKFILL SHALL BE COMPACTED AS SPECIFIED.

ALL EXISTING INVERTS & LOCATIONS SHALL BE VERIFIED PRIOR TO CONSTRUCTION. ALL DISCREPANCIES FROM INFORMATION SHOWN ON THE PLANS SHALL BE REPORTED TO THE ENGINEER IMMEDIATELY.


CONTRACTOR SHALL IDENTIFY & MARK THE EXACT LOCATIONS OF ALL UNDERGROUND CONNECTIONS TO WATER AND SEWER MAINS, BENDS, CURB BOXES, CLEAN OUTS, ETC. ON THE AS-BUILT PLANS. COPIES OF THESE DOCUMENTS SHALL BE DELIVERED TO THE ENGINEER FOR RECORD.

LOCATION REQUIREMENT: NON-METALLIC SEWER MAINS AND SERVICES MUST BE PROVIDED WITH TRACE WIRE OR OTHER METHODS IN ORDER TO BE LOCATED.

SHOP DRAWINGS FOR UTILITIES ARE REQUIRED.

ALL MANHOLES SHALL BE BUILT WITH ECCENTRIC CONES.

- CONSTRUCTION BULLETIN #1**
- NDS INLET #12 ELEVATION CHANGE
 - NDS INLET #11 RIM ELEVATION CHANGE
 - BIOFILTER #2 SIZE CHANGE AND CORRESPONDING PIPE LENGTHS
- CONSTRUCTION BULLETIN #2**
- NDS INLET #1 CONNECTS TO 48" PIPE (AND CHANGE IN 12" PIPE LENGTH)
 - INVERT CHANGES TO NDS INLETS #1 & #2 AND STORM MH #1
 - NDS INLET #13 AND DOWNSPOUTS CONNECT TO 48" PIPE (AND CORRESPONDING PIPE LENGTHS)
 - INVERT CHANGES TO STORM MH #2
 - ADD HEX NOTE #8
- CONSTRUCTION BULLETIN #4**
- ADD HEX NOTE #9
- CONSTRUCTION BULLETIN #5**
- UNDERGROUND STORAGE SYSTEM ON SOUTH SITE SHIFTED SOUTHWEST TO ACCOMMODATE INCREASED SIZE OF BUILDING. INVERTS AND PIPE LENGTHS ADJUSTED FOR NEW LOCATION OF SYSTEM.

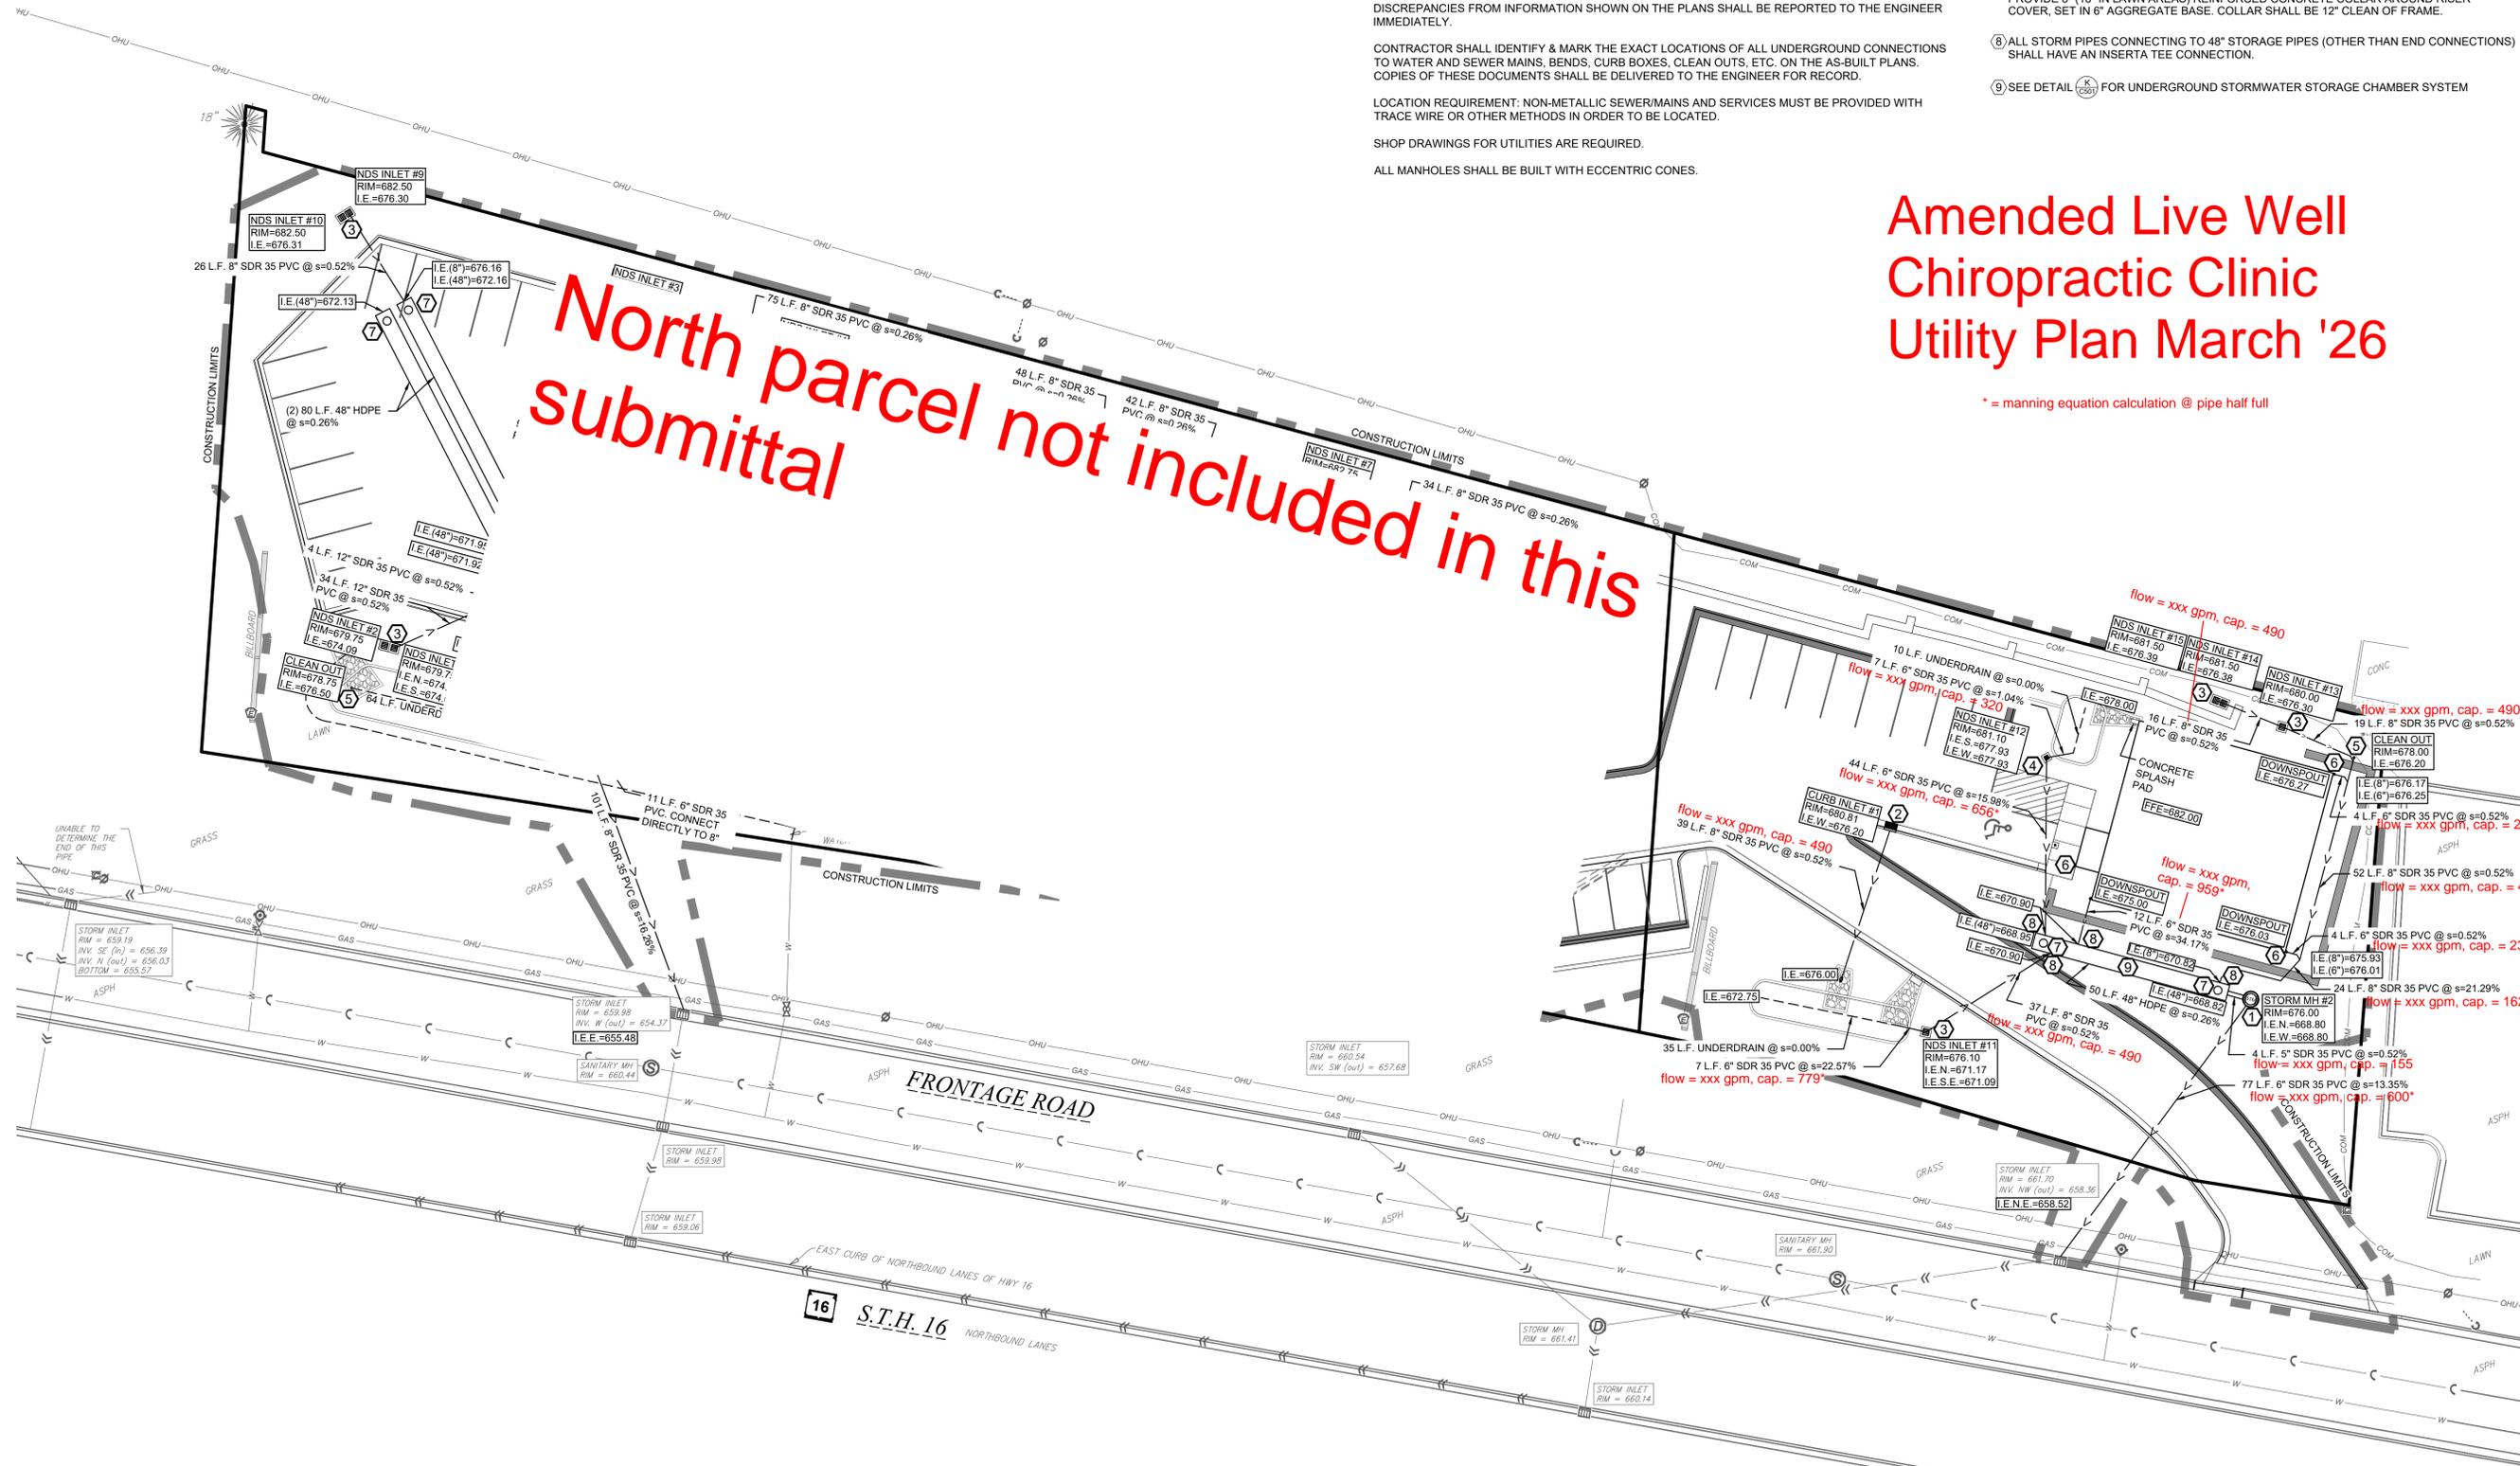

North parcel not included in this submittal

Amended Live Well Chiropractic Clinic Utility Plan March '26

* = manning equation calculation @ pipe half full

