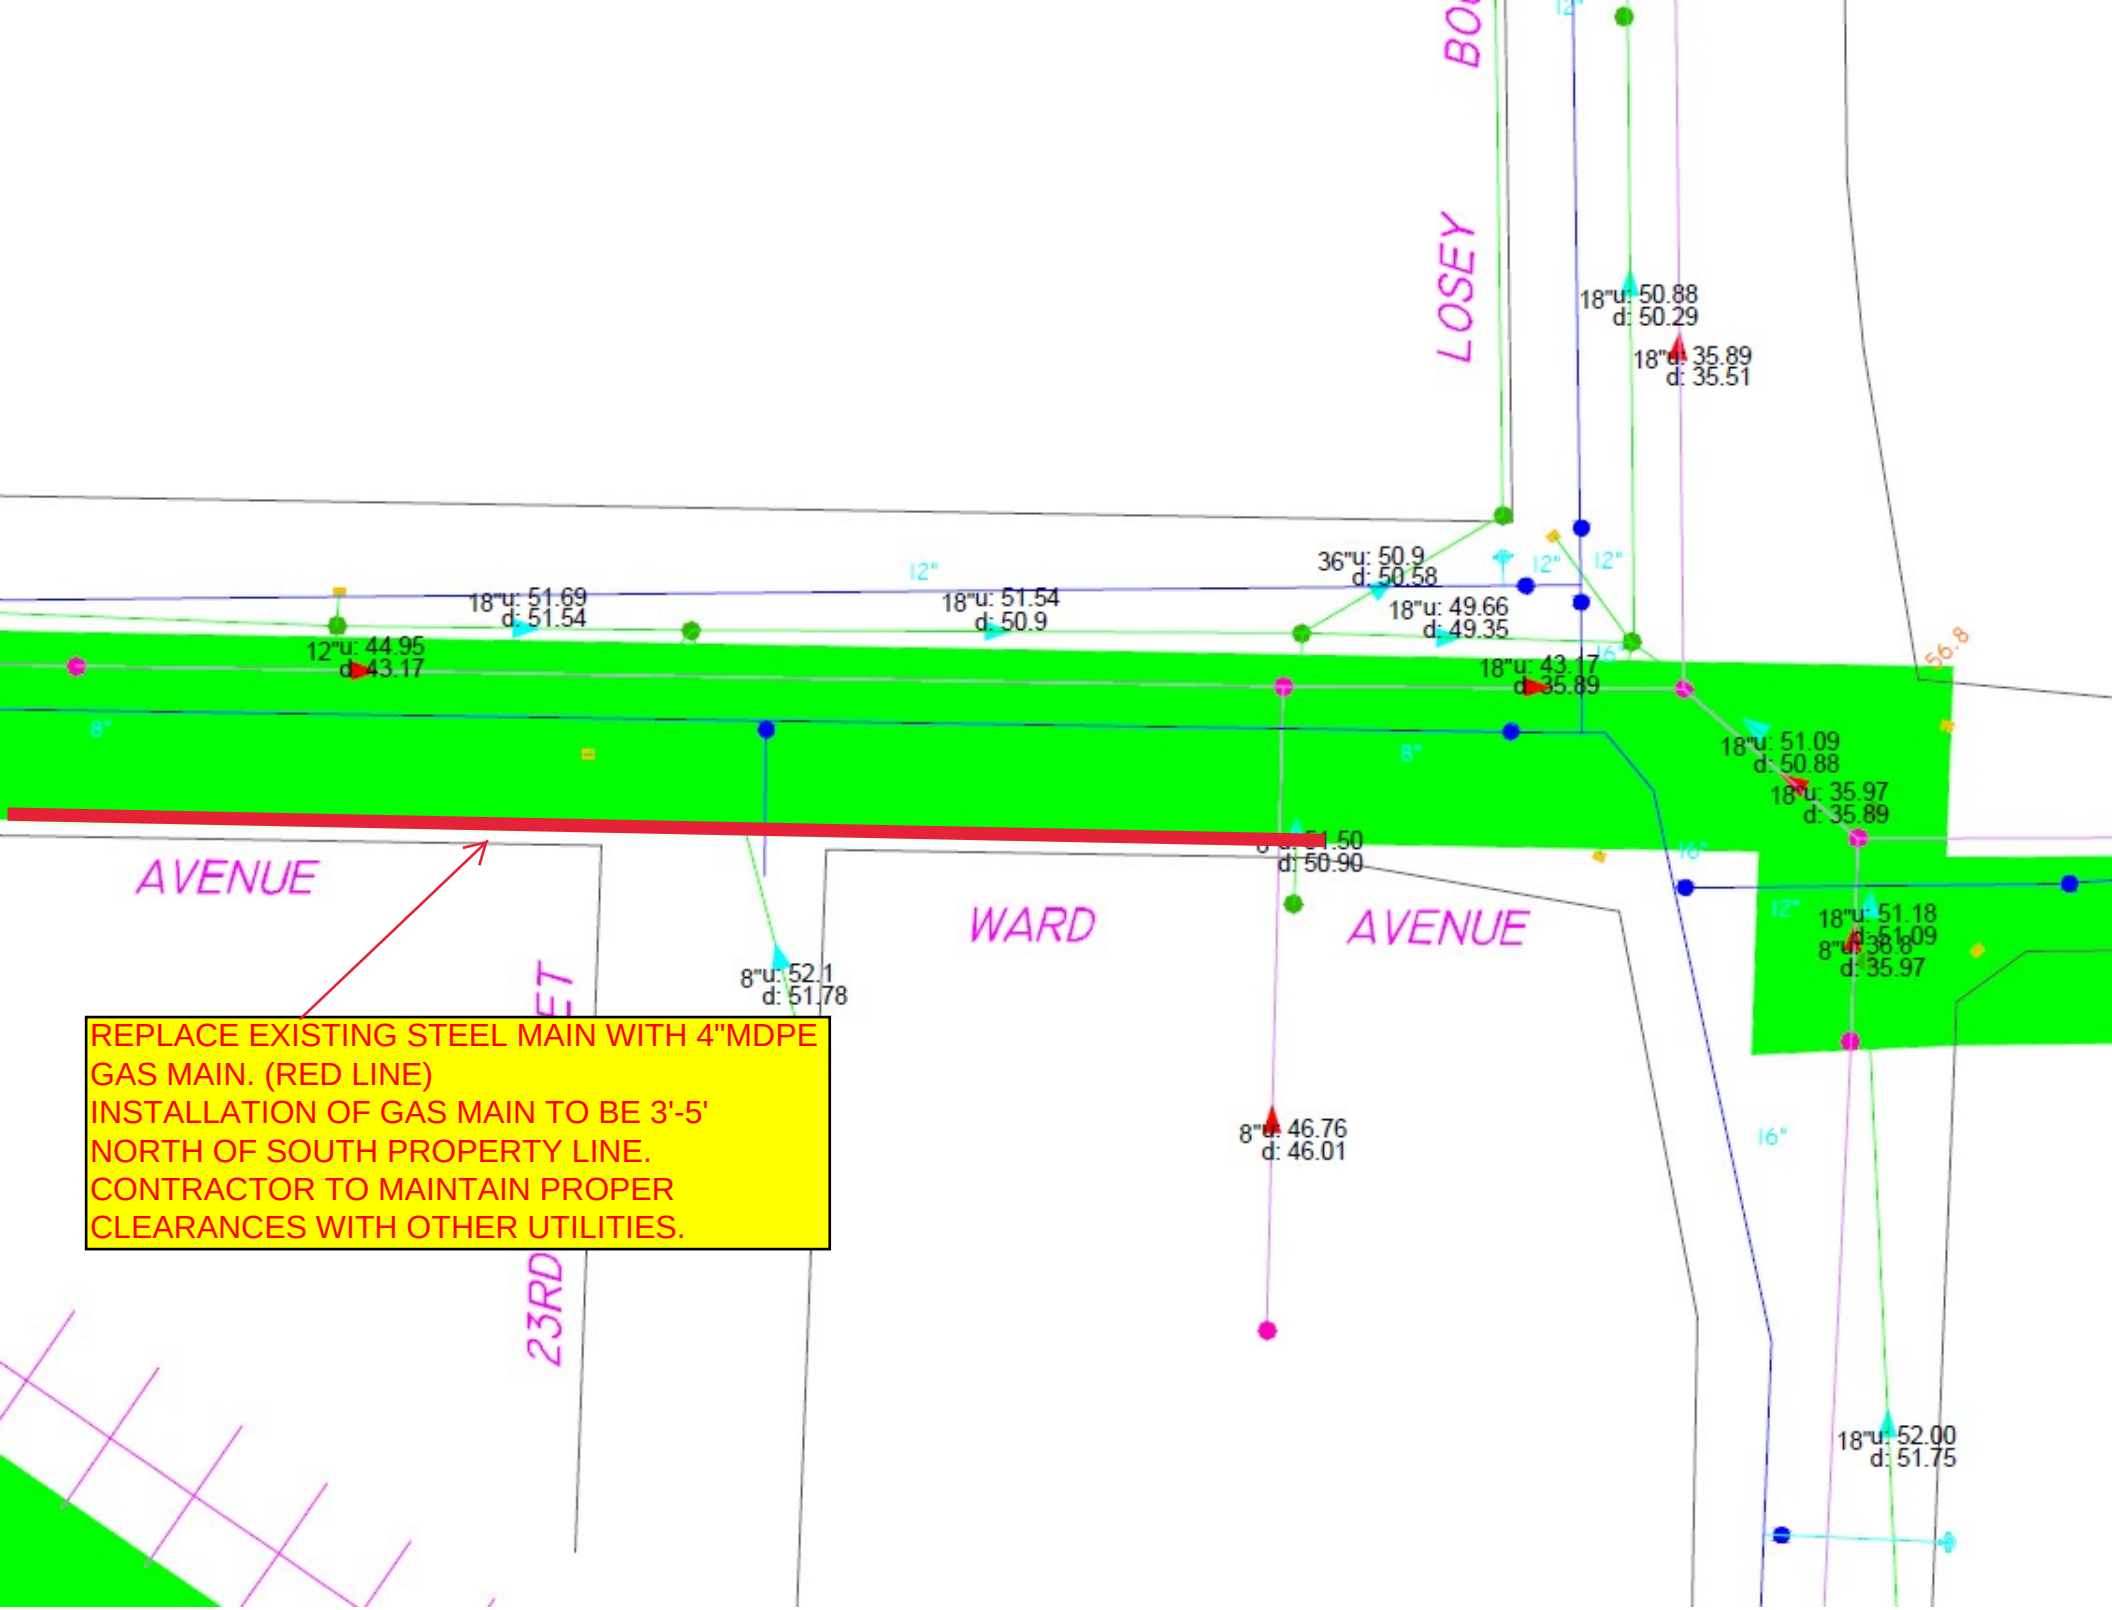
LOSEY
AVENUE
WARD
AVENUE
23RD
18"u: 50.88
d: 50.29
18"u: 35.89
d: 35.51
36"u: 50.9
d: 50.58
18"u: 49.66
d: 49.35
18"u: 51.69
d: 51.54
12"u: 44.95
d: 43.17
18"u: 51.54
d: 50.9
18"u: 43.17
d: 35.89
18"u: 51.09
d: 50.88
18"u: 35.97
d: 35.89
d: 50.90
8"u: 52.1
d: 51.78
8"u: 46.76
d: 46.01
18"u: 51.18
d: 51.09
8"u: 38.8
d: 35.97
18"u: 52.00
d: 51.75
REPLACE EXISTING STEEL MAIN WITH 4"MDPE GAS MAIN. (RED LINE)
INSTALLATION OF GAS MAIN TO BE 3'-5' NORTH OF SOUTH PROPERTY LINE.
CONTRACTOR TO MAINTAIN PROPER CLEARANCES WITH OTHER UTILITIES.